



PATENT

IN THE UNITED STATES PATENT AND TRADEMARK OFFICE

Applicant : Salvatore Leonardi  
Application No. : 09/853,833  
Filed : May 10, 2001  
For : INTEGRATED DEVICE WITH A TRENCH ISOLATION  
STRUCTURE, AND FABRICATION PROCESS THEREFOR

Examiner : Leonardo Andujar  
Art Unit : 2826  
Docket No. : 856063.694  
Date : September 30, 2002


Commissioner for Patents  
Washington, DC 20231

REQUEST FOR DRAWING CHANGE

Commissioner for Patents:

Drawing changes, as indicated in red on the attached drawings, are hereby submitted for approval by the Examiner.

Respectfully submitted,  
Salvatore Leonardi  
Seed Intellectual Property Law Group PLLC

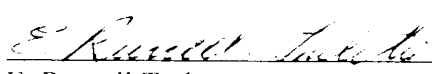  
E. Russell Tarleton  
Registration No. 31,800

ERT:aep  
Enclosure:  
Redlined Figures 3, 9, and 10

701 Fifth Avenue, Suite 6300  
Seattle, Washington 98104-7092  
Phone: (206) 622-4900  
Fax: (206) 682-6031

RECEIVED  
OCT 1 2002  
TECHNOLOGY CENTER 2800

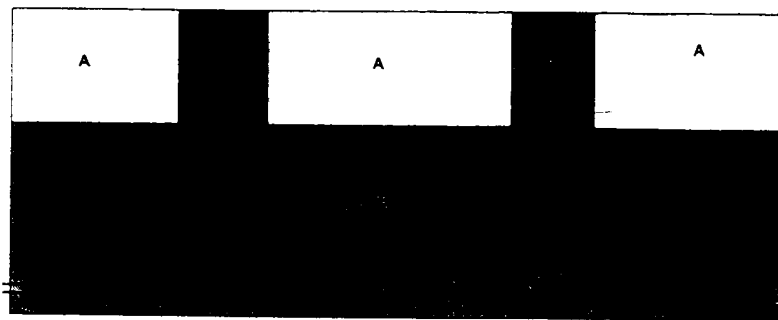


Figura 1

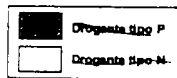


Figura 2

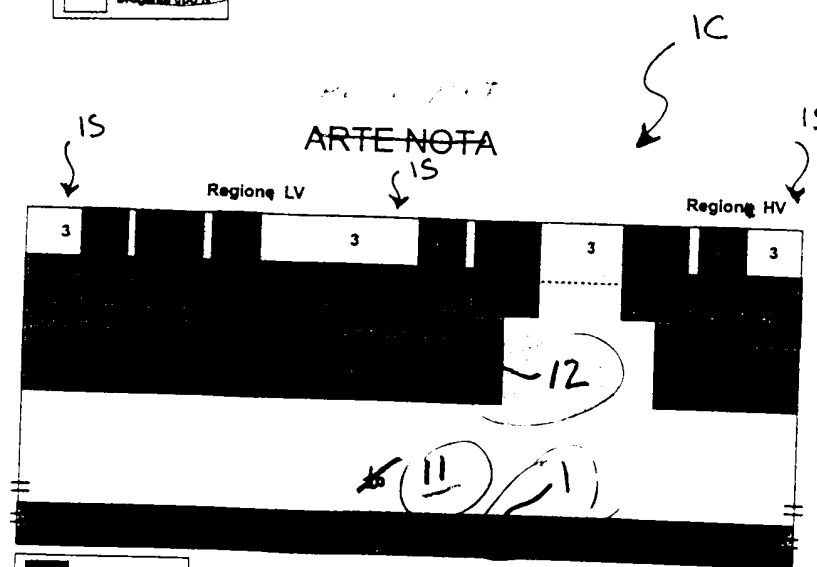
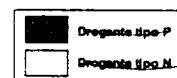


Figura 3



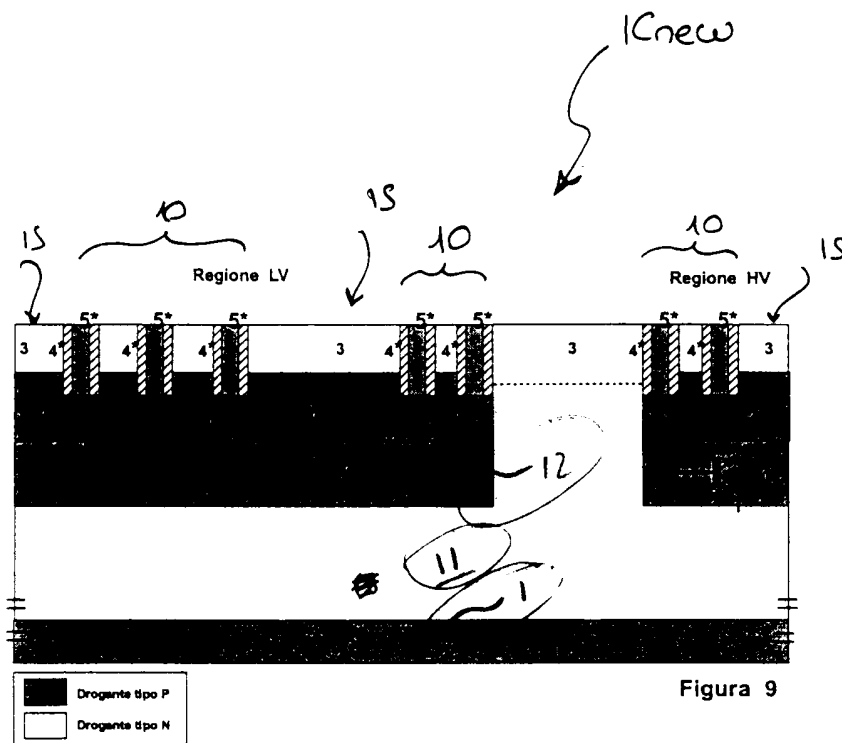


Figura 9

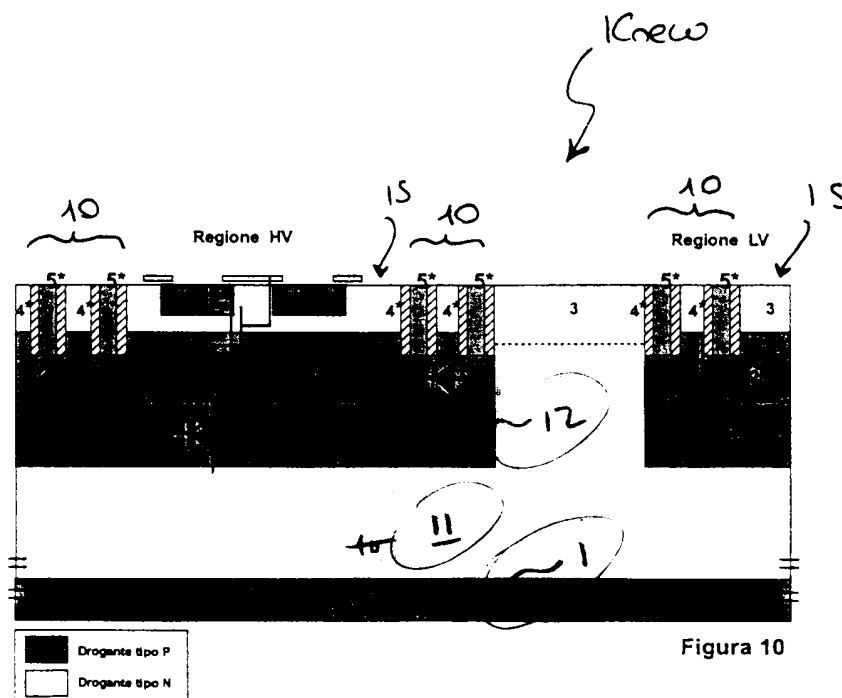


Figura 10